



UNINTECH CONSULTING ENGINEERS, INC.

STRUCTURAL • CIVIL • SURVEYING

INVOICE

To:
DR Horton Homes
5419 N. Loop 1604 E
San Antonio, TX 78247


Invoice Number: 225033-S
Invoice Date: Jul 11, 2025
Page: 1

Customer ID	Payment Terms	Due Date
D024	Net 30 Days	8/10/25

Description	Amount
Winding Creek 211-6-2 Order #277700211 Plan #X30C-BL 1530 Champagne Oak - As Built Survey for Construction Package	385.00
	

Check No:

Subtotal: 385.00
Sales Tax:
Total Invoice Amount: 385.00
Payment Received:
TOTAL 385.00

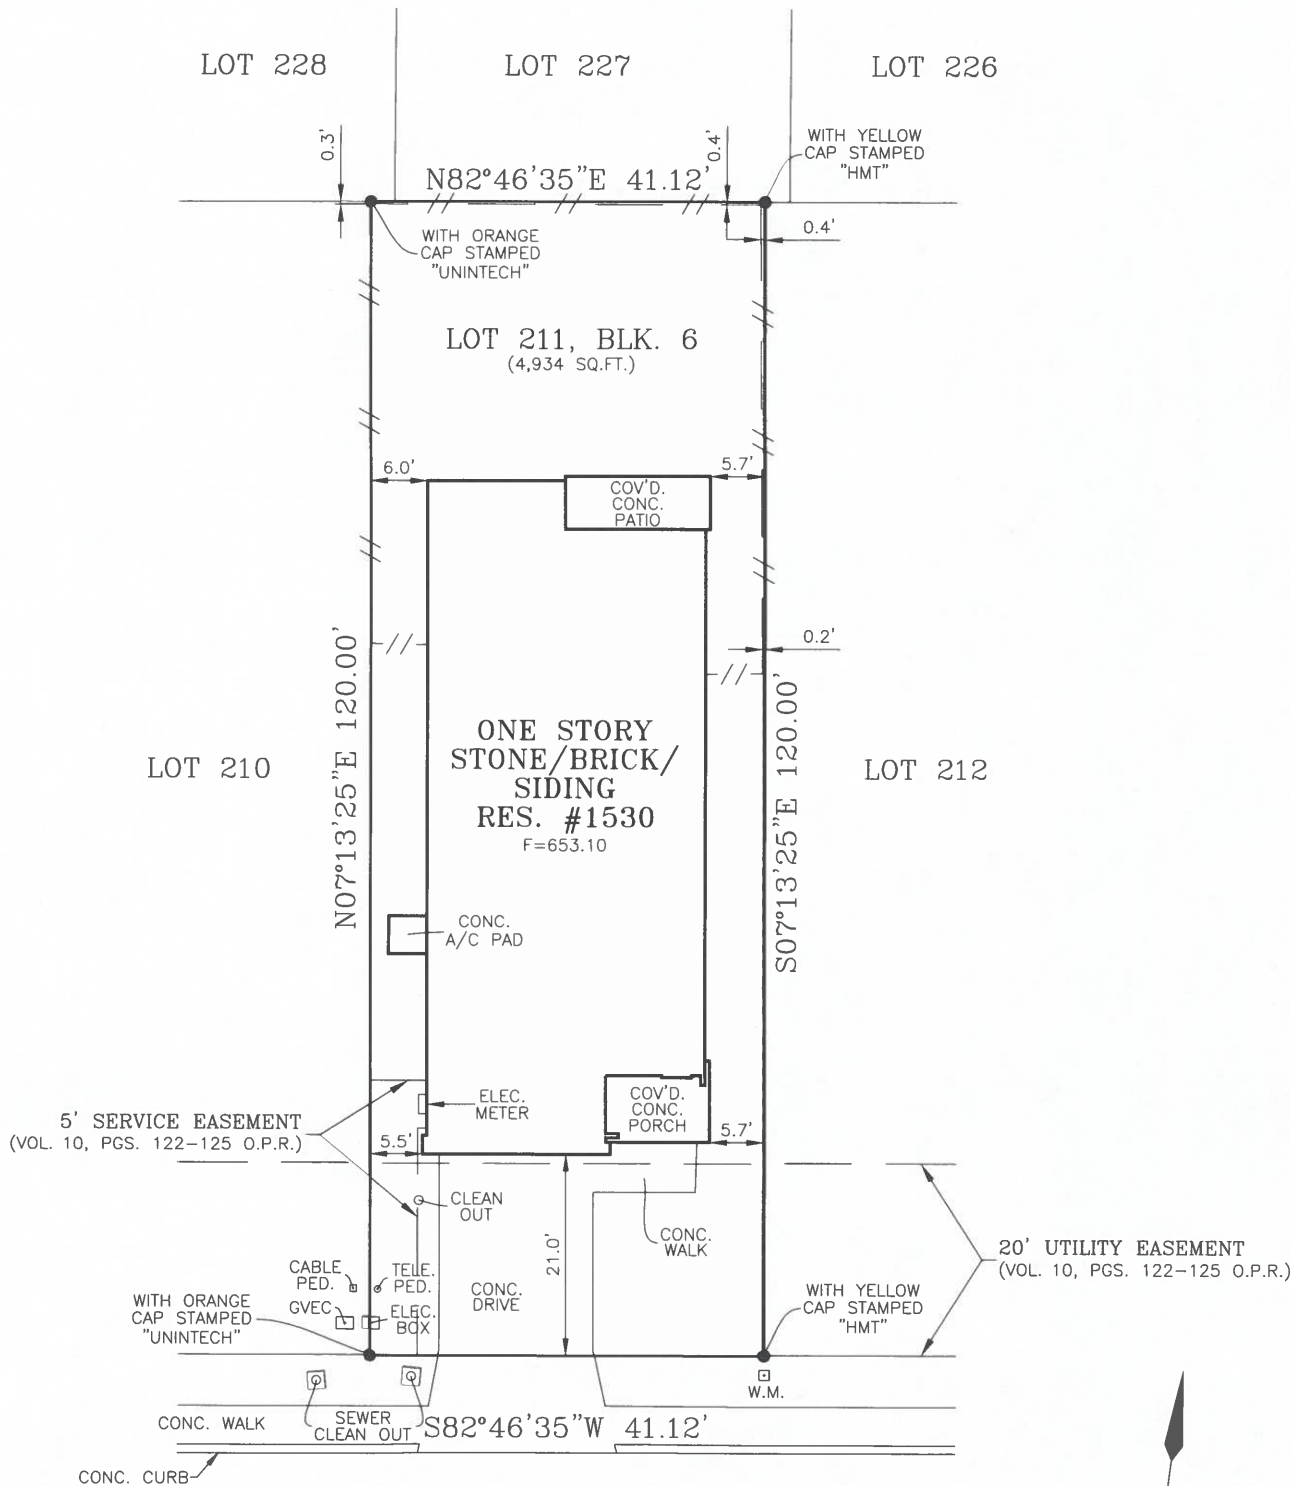

CHAMPAGNE OAK

(50' R.O.W.)
(VOL. 10, PGS. 122-125 O.P.R.)

0 10 20
FEET
SCALE: 1" = 20'

LOT 211, BLOCK 6,
SUBDIVISION WINDING CREEK RANCH, UNIT 2,
VOL. 10, PGS. 122-125 O.P.R.
STREET ADDRESS 1530 CHAMPAGNE OAK
CITY NEW BRAUNFELS, GUADALUPE COUNTY, TEXAS,
TITLE COMPANY --
SURVEYED FOR: D.R. HORTON

NOTE:

- ACCORDING TO SCALING FROM THE F.E.M.A. FLOOD INSURANCE RATE MAP NO. 48187C0255F DATED NOVEMBER 2, 20 07, THIS TRACT LIES WITHIN THE UNSHADED ZONE X AREA DETERMINED TO BE OUTSIDE THE 0.2% ANNUAL CHANCE FLOODPLAIN. THIS FLOOD STATEMENT SHALL NOT CREATE LIABILITY ON THE PART OF THE SURVEYOR.
- THIS SURVEY ONLY REFLECTS RECORDED PLAT ENCUMBRANCES.
- SURVEYOR DID NOT ABSTRACT THIS PROPERTY.
- SURVEY WAS PERFORMED WITHOUT THE BENEFIT OF A TITLE COMMITMENT.
- THIS IS NOT A TOPOGRAPHIC SURVEY AND ELEVATIONS SHOWN ARE FOR REFERENCE ONLY.

THIS PROPERTY IS SUBJECT TO RESTRICTIVE COVENANTS RECORDED IN:
THE DOCUMENTS LISTED BELOW MAY OR MAY NOT AFFECT SUBJECT TRACT.
DOC. # 202399013959; DOC. # 202399021566; DOC. # 202499003415
DOC. # 202399014015; DOC. # 202399027990; DOC. # 202399031541
DOC. # 202399014017; DOC. # 202399028898; DOC. # 202399014936
DOC. # 202399014018; DOC. # 202399029216
DOC. # 202399023048 (PLAT); VOL. 10, PG. 122-125 (PLAT)

UNINTECH CONSULTING ENGINEERS, INC.



2431 EAST EVANS ROAD
SAN ANTONIO, TEXAS 78259
(210) 641-6003 FAX: (210) 641-8279

WWW.UNINTECH.COM
TBPLS NO. 100511-00
TBPE REG. NO. F-5499



LEGEND			
F=000.0	FINISH FLOOR ELEVATION	●	FOUND 1/2" IRON ROD (UNLESS OTHERWISE SPECIFIED)
X 1190.84	FIELD ELEVATION	○	SET 1/2" IRON ROD WITH "UNINTECH" STAMP
---	WOOD FENCE	□ W.M.	WATER METER
○	IRON FENCE	□ W.V.	WATER VALVE
□ TRANS.	TRANSFORMER	R.P.R.: REAL PROPERTY RECORDS, GUADALUPE COUNTY, TEXAS O.P.R.: OFFICIAL PUBLIC RECORDS GUADALUPE COUNTY, TEXAS	
TELE. PED.	TELEPHONE PEDESTAL		
ELEC. BOX	ELECTRICAL BOX		
CABLE PED.	CABLE PEDESTAL		
→	DRAINAGE FLOW	BEARING BASIS IS BASED ON SUBDIVISION PLAT.	
F.H.	FIRE HYDRANT		
T.C. 000.00	TOP OF CURB ELEVATION		
G. 000.00	GUTTER ELEVATION		
⊙ P.P.	POWER POLE		
⊙ L.P.	LIGHT POLE		

I HEREBY CERTIFY THAT THE ABOVE PLAT IS AN ACCURATE REPRESENTATION OF THE PROPERTY ACCORDING TO AN ACTUAL SURVEY MADE ON THE GROUND UNDER MY SUPERVISION ON:

THIS 10TH DAY OF JULY, 20 25 A.D.

[Signature]

SCALE 1"=20' DWN BY: SB CHK BY: MS
REV./ UPDATED: