


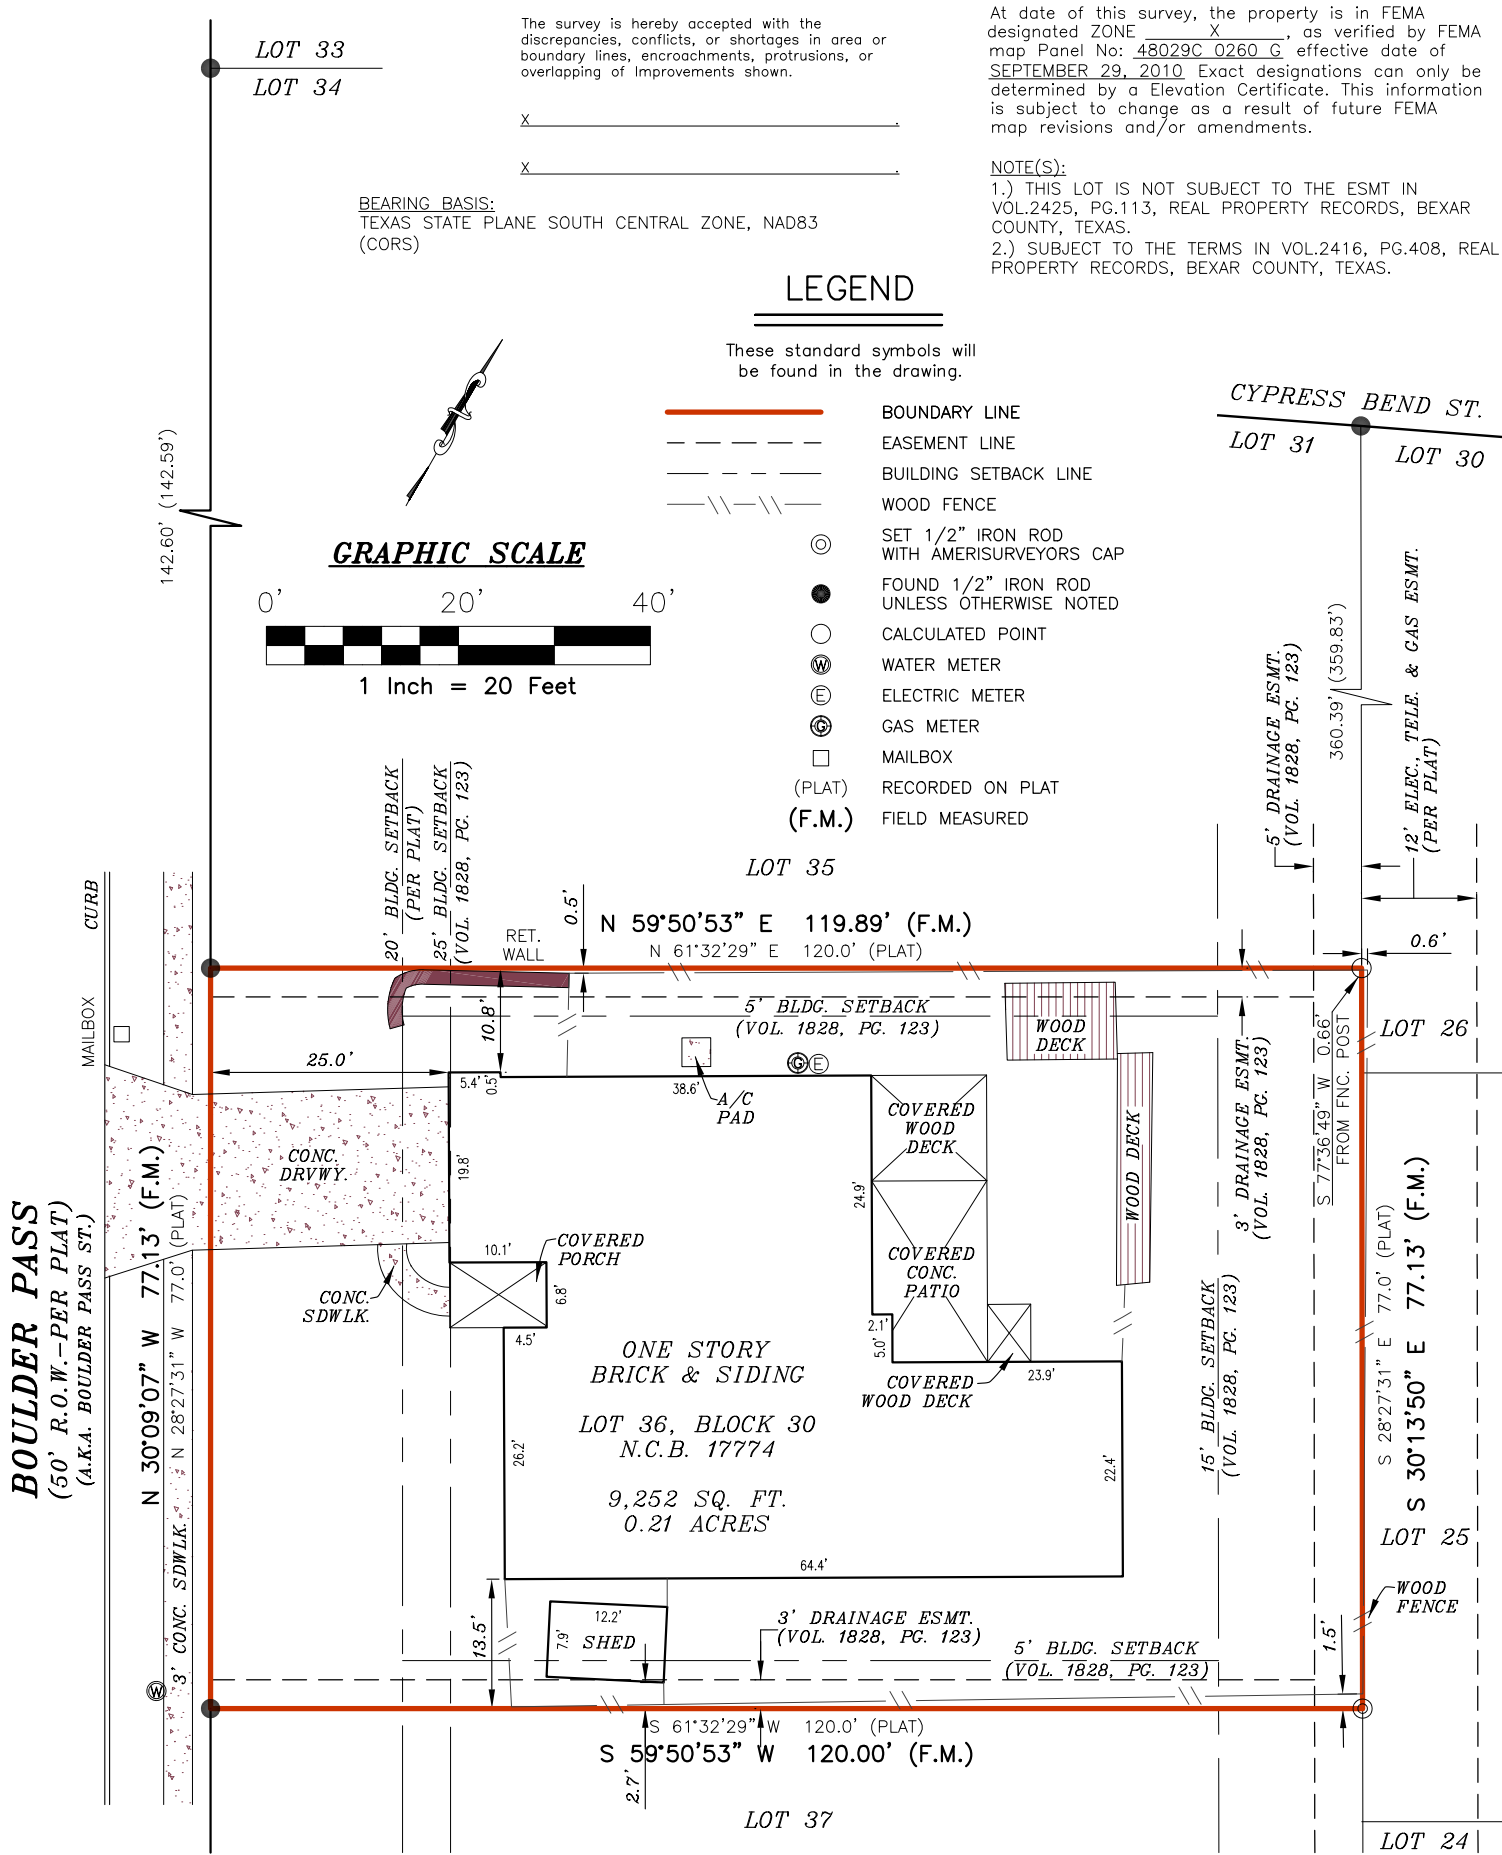

I, RACHEL LYNN HANSEN, a Registered Professional Land Surveyor in the State of Texas, do hereby certify to HOMeward TITLE, LLC and PURCHASING FUND 2025-1, LLC/ ASSIGNS LLC, A DELAWARE LIMITED LIABILITY COMPANY that the above map is true and correct according to an actual field survey, made by me on the ground or under my supervision, of the property shown hereon. I further certify that all easements and rights-of-way of which I have been advised are shown hereon and that, except as shown, there are no visible encroachments, no visible overlapping of improvements and no apparent discrepancies or conflicts in the boundary lines, and no visible physical evidence of easements or rights-of-way as of the date of the field survey. I further certify that this survey meets or exceeds the minimum standards established by the Texas Board of Professional Engineers and Land Surveyors (Section 138.89).

Borrower/Owner: PURCHASING FUND 2025-1, LLC/ ASSIGNS LLC, A DELAWARE LIMITED LIABILITY COMPANY
Address: 16314 BOULDER PASS ST. GF No. HTT-26-12519

Legal Description of the Land: Lot 36, Block 30, New City Block 17774, of HIGH COUNTRY SUBDIVISION, UNIT 9, an addition to the City of San Antonio, Bexar County, Texas, according to plat thereof recorded in Volume 8700, Page 85, of the Deed and Plat Records of Bexar County, Texas.

SUBJECT TO RESTRICTIVE COVENANTS AND/OR EASEMENTS RECORDED IN: VOLUME 8700, PAGE 85, DEED AND PLAT RECORDS, BEXAR COUNTY, TEXAS VOLUME 1828, PAGE 123, REAL PROPERTY RECORDS, BEXAR COUNTY, TEXAS

 **AMERISURVEYORS**
EXCELLENCE IN LAND SURVEYING

P.O. BOX 160369
SAN ANTONIO, TEXAS 78280
PHONE: (210) 572-1995
WEB: WWW.AMERISURVEYORS.COM



FINAL "AS-BUILT" SURVEY

JOB NO.:	2607111595	NO.	REVISION	DATE
DATE:	07/23/26			
DRAWN BY:	JD/TW/RLD			
APPROVED BY:	RLH			




RACHEL LYNN HANSEN, R.P.L.S.
Registered Professional Land Surveyor
Registration No. 6358