



CURVE	RADIUS	ARC LENGTH	CHORD LENGTH	CHORD BEARING	DELTA ANGLE
C1	50.00'	18.81'	--	--	--
C2	50.00'	18.60'	18.49'	N 76°14'07" W	21°18'38"

SURVEYOR'S NOTE(S):
 SIDE FENCE LIES INTO LOT 32.
 REAR FENCE LIES INTO CALLED 34.60 ACRE TRACT.

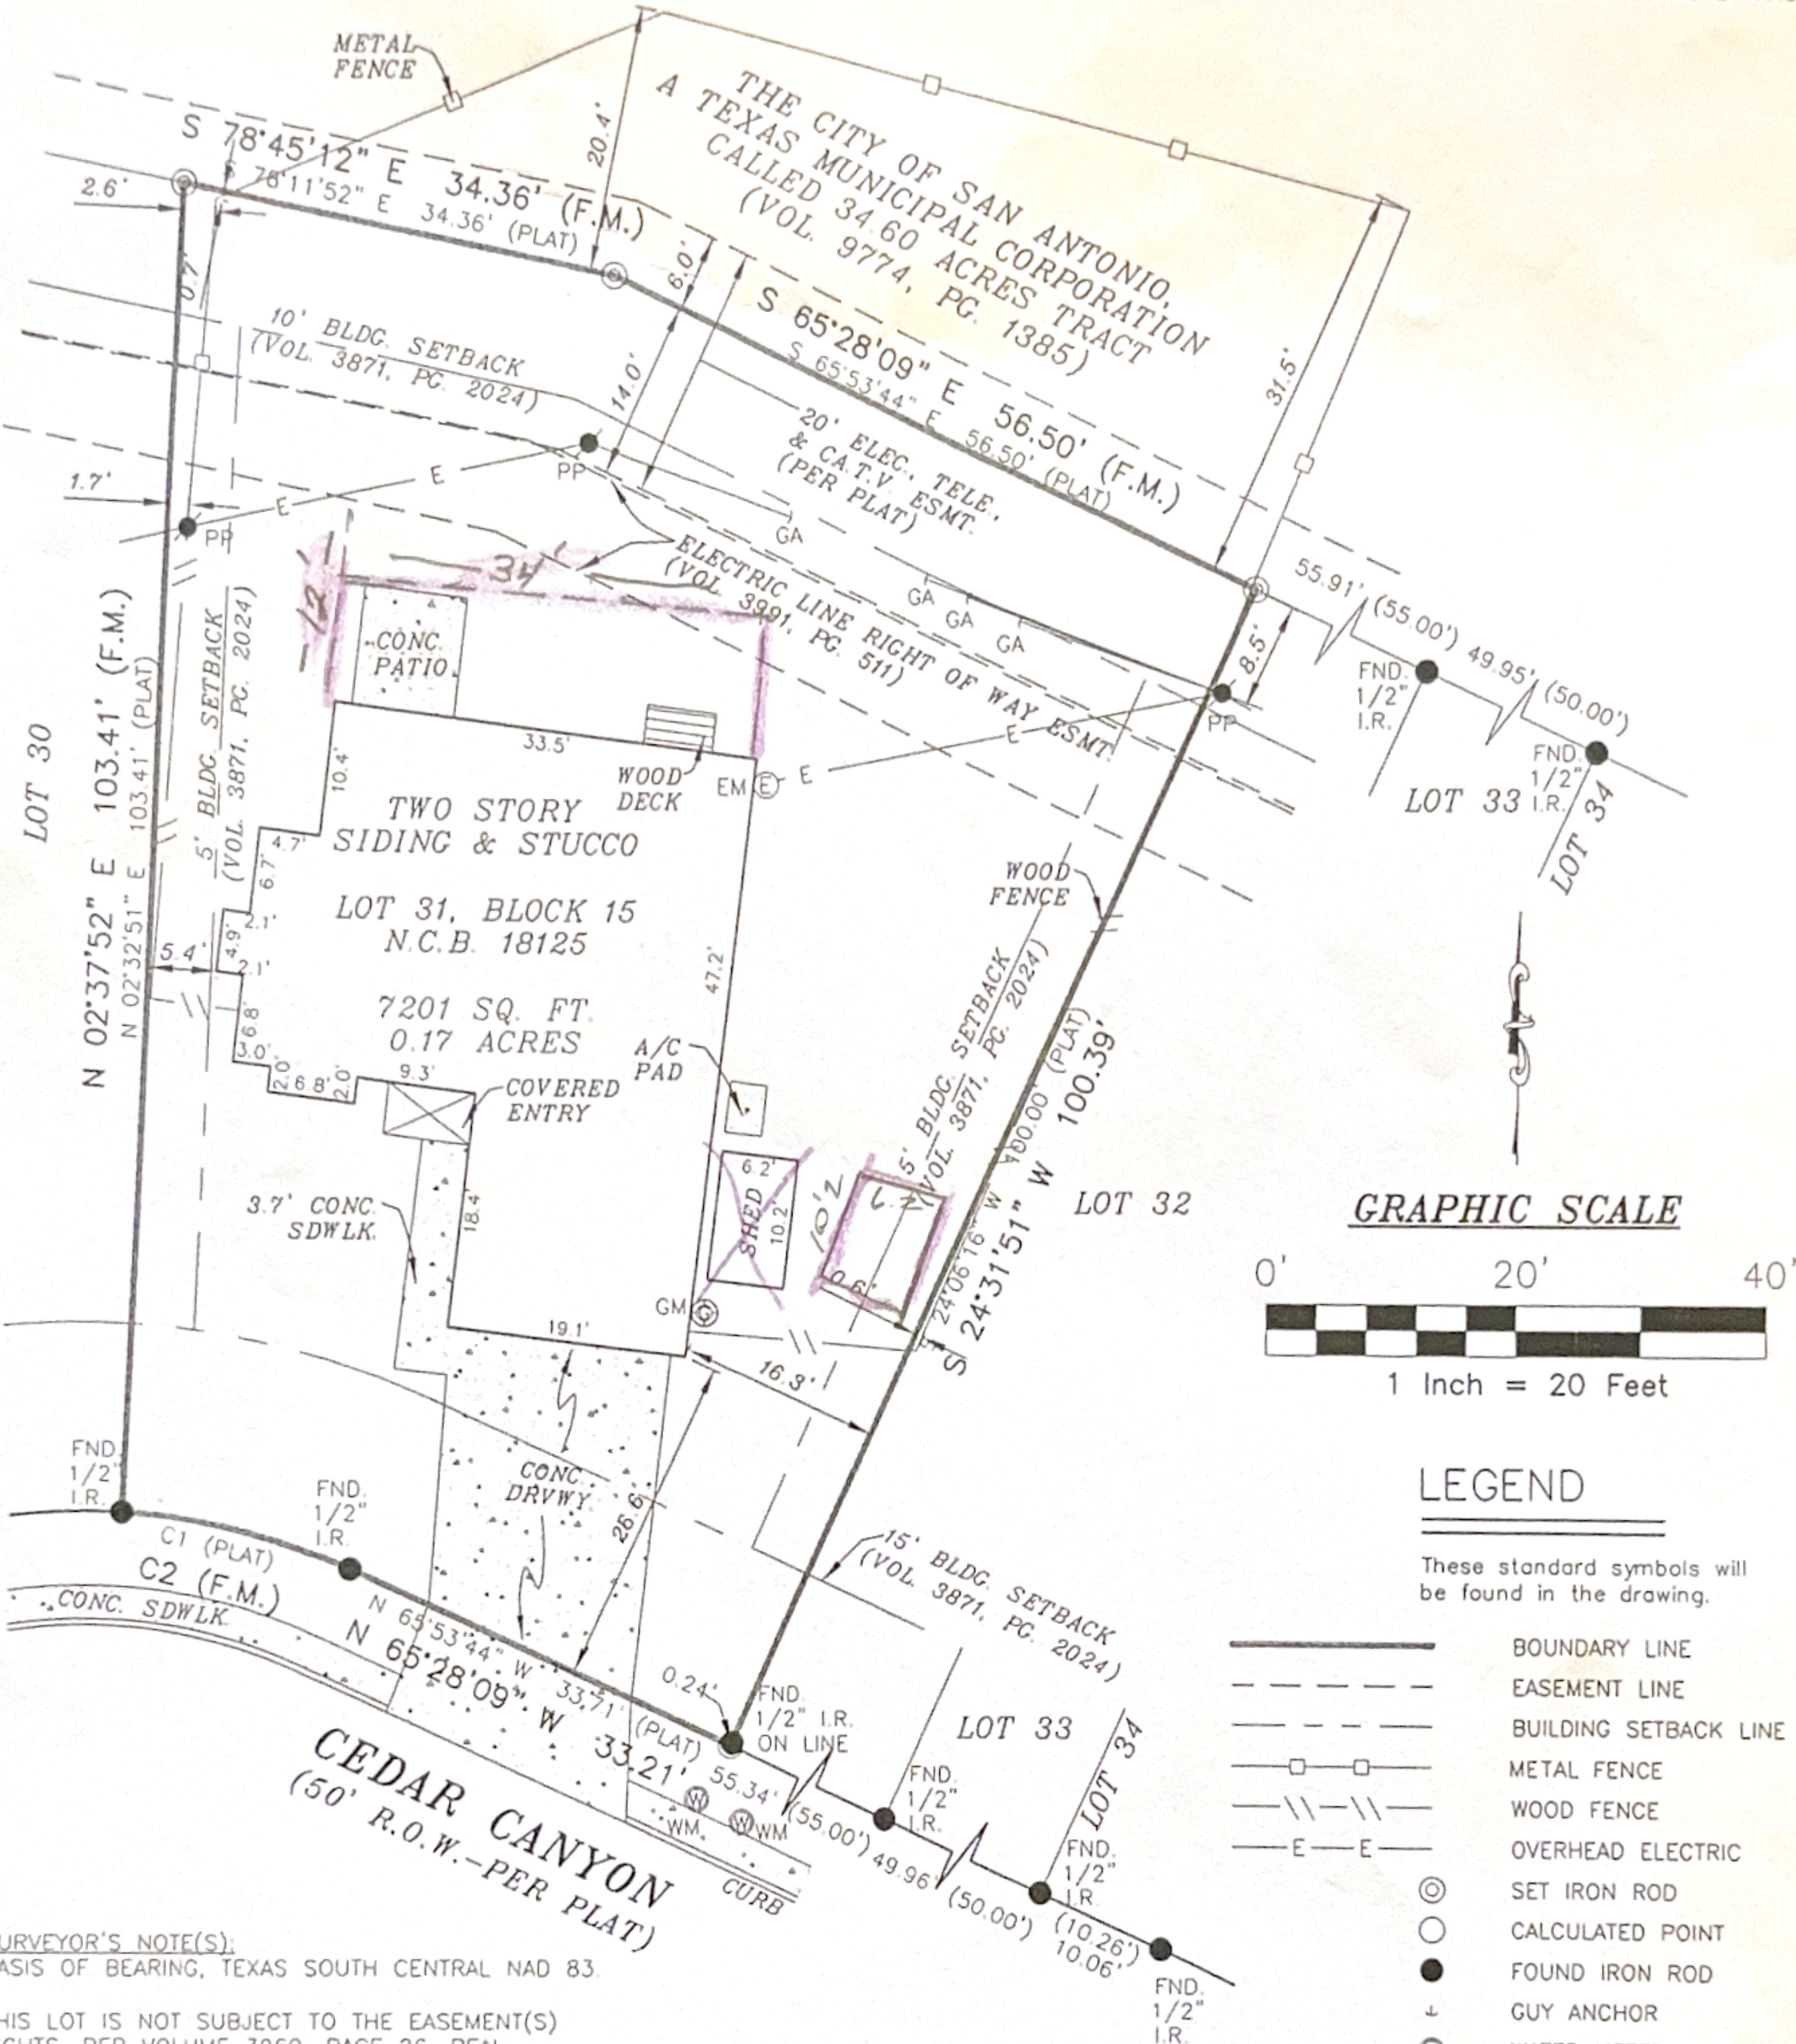

GRAPHIC SCALE

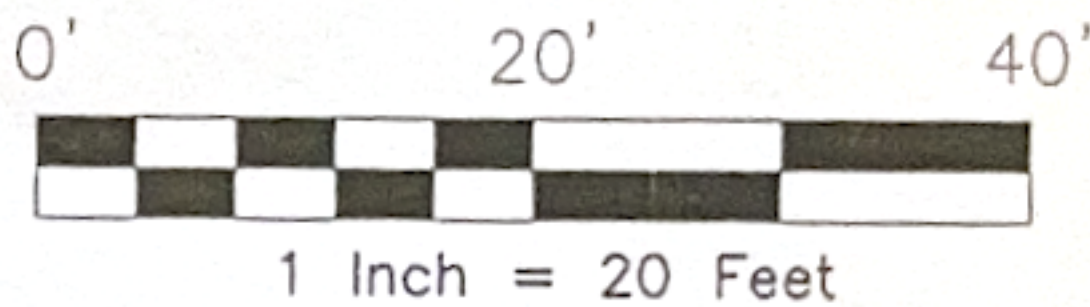

LEGEND

These standard symbols will be found in the drawing.

- BOUNDARY LINE
- - - EASEMENT LINE
- - - BUILDING SETBACK LINE
- METAL FENCE
- WOOD FENCE
- OVERHEAD ELECTRIC
- ⊙ SET IRON ROD
- CALCULATED POINT
- FOUND IRON ROD
- ⊥ GUY ANCHOR
- ⊙ WATER METER
- ⊙ ELECTRIC METER
- ⊙ GAS METER
- POWER POLE
- (PLAT) RECORDED ON PLAT
- (F.M.) FIELD MEASURED

SURVEYOR'S NOTE(S):
 BASIS OF BEARING, TEXAS SOUTH CENTRAL NAD 83.

THIS LOT IS NOT SUBJECT TO THE EASEMENT(S) RIGHTS, PER VOLUME 3960, PAGE 26, REAL PROPERTY RECORDS, BEXAR COUNTY, TEXAS.

At date of this survey, the property is in FEMA designated ZONE X as verified by FEMA map Panel No: 48029C 0235 G effective date of SEPTEMBER 29, 2010. Exact designations can only be determined by a Elevation Certificate. This information is subject to change as a result of future FEMA map revisions and/or amendments.

The survey is hereby accepted with the discrepancies, conflicts, or shortages in area or boundary lines, encroachments, protrusions, or overlapping of improvements shown.

La Rita Morris Burrow
Jeffrey Lynn Burrow

I, JOSE ANTONIO TREVINO, a Registered Professional Land Surveyor in the State of Texas, do hereby certify to CHICAGO TITLE OF TEXAS, LLC

and that the above map is true and correct according to an actual field survey, made by me on the ground or under my supervision, of the property shown hereon or described by field notes accompanying this drawing. I further certify that all easements and rights-of-way of which I have been advised are shown hereon and that, except as shown, there are no visible encroachments, no visible overlapping of improvements and no apparent discrepancies or conflicts in the boundary lines, and no visible physical evidence of easements or rights-of-way as of the date of the field survey. I further certify that this survey meets or exceeds the minimum standards established by the Texas Board of Professional Land Surveying (Section 663.18).

Borrower/Owner: LA RITA MORRIS BURROW AND JEFFREY LYNN BURROW
 Address: 14064 CEDAR CANYON GF No. SCT-67-43002820038131
 Legal Description of the Land: Lot 31, Block 15, New City Block 18125, Castle Hills Forest Unit 8, (Planned Unit Development), City of San Antonio, Bexar County, Texas, according to the map or plat thereof recorded in Volume 9514, Pages 38-40, Deed and Plat Records of Bexar County, Texas.

SUBJECT TO RESTRICTIVE COVENANTS AND/OR EASEMENTS RECORDED IN: VOLUME 9514, PAGE(S) 38-40, DEED AND PLAT RECORDS, BEXAR COUNTY, TEXAS
 VOLUME 3871, PAGE 2024, REAL PROPERTY, BEXAR COUNTY, TEXAS
 VOLUME 3991, PAGE 511, REAL PROPERTY, BEXAR COUNTY, TEXAS

PROPERTY PHOTOGRAPH:



FINAL "AS-BUILT" SURVEY

JOB NO.:	2007071315	NO	REVISION	DATE
DATE:	08/03/20			
DRAWN BY:	JD/FR/MF			
APPROVED BY:	JAT			



Jose Antonio Trevino
 JOSE ANTONIO TREVINO, R.P.L.S.
 Registered Professional Land Surveyor
 Registration No. 5552



AMERISURVEYORS, LLC
 1100 NW Loop 410, Suite 546
 Phone: (210) 572-1995
 San Antonio, Texas 78213
 Fax: (210) 572-1993