
LEGEND:

- ● CALCULATED POINT (NO MONUMENT SET)
- ○ FOUND 1/2" STEEL REBAR (UNLESS OTHERWISE NOTED)
- D.P.R. DEED AND PLAT RECORDS OF BEXAR COUNTY, TEXAS
- —o— WOOD FENCE
- —\/\— WROUGHT IRON FENCE
- C.M. CONTROLLING MONUMENT

SCALE 1"=20'

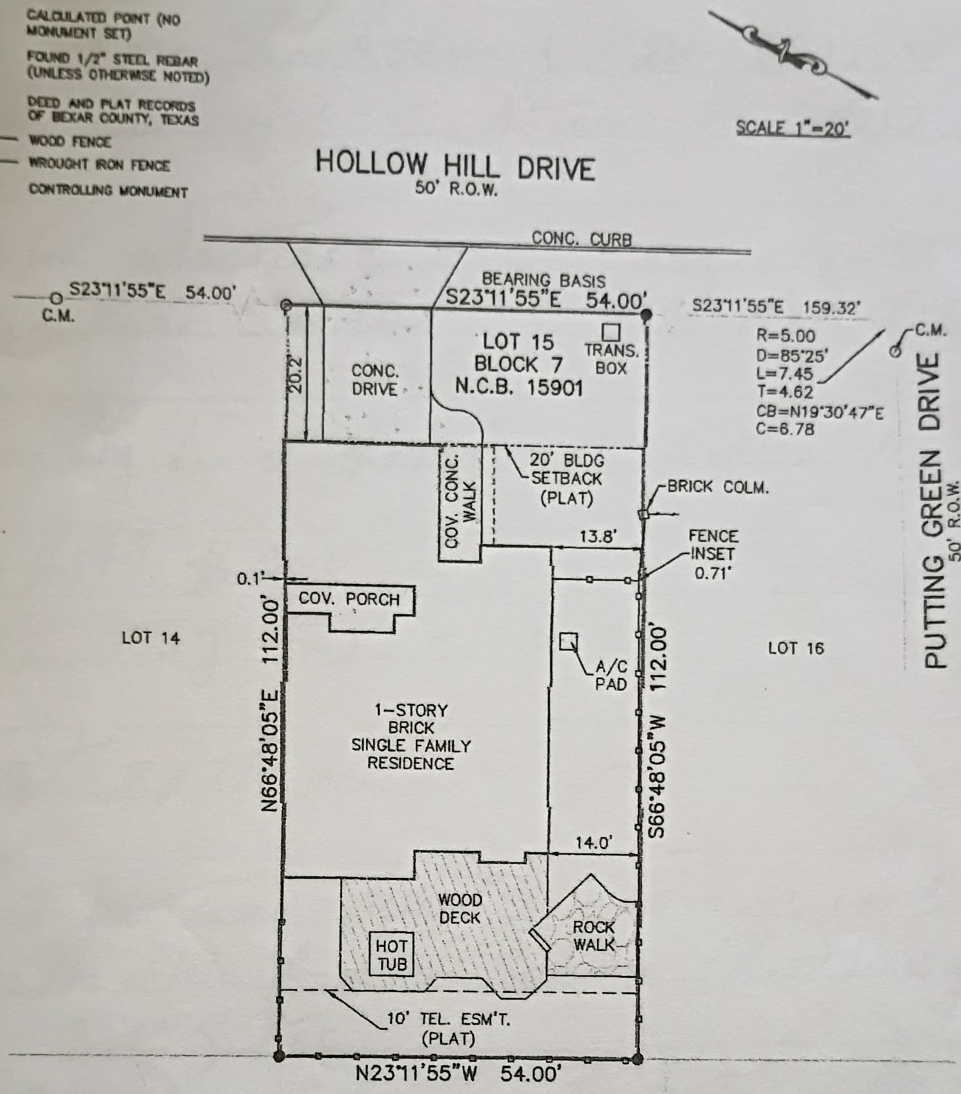

OWNER: DOUGLAS L GLASSFORD & MARSH GLASSFORD
ADDRESS : 4334 HOLLOW HILL DRIVE
CITY: SAN ANTONIO, COUNTY : BEXAR, STATE : TEXAS

LOT 15, BLOCK 7, N.C.B. 15901, ACCORDING TO THE PLAT OF NORTHERN HILLS, UNIT - 5A, RECORDED IN VOLUME 8100, PAGE 142, DEED & PLAT RECORDS OF BEXAR COUNTY TEXAS.

NOTES:

1. BEARINGS FOR THIS SURVEY ARE BASED ON THE PLAT OF NORTHERN HILLS, UNIT - 5A SUBDIVISION RECORDED IN VOLUME 8100, PAGE 142 OF THE DEED AND PLAT RECORDS OF BEXAR COUNTY, TEXAS.
2. THIS SURVEY WAS PERFORMED WITHOUT THE BENEFIT OF A TITLE COMMITMENT. THERE MAY BE BUILDING SETBACKS, RESTRICTIONS, OR EASEMENTS THAT MAY AFFECT THE PROPERTY THAT ARE NOT SHOWN HEREON. OWNER/BUILDER/ARCHITECT SHALL VERIFY ALL OF THE ABOVE PRIOR TO CONSTRUCTION.

DYE ENTERPRISES
ENGINEERS • SURVEYORS • PLANNERS
TBPE, FIRM REGISTRATION #F-2257
TBPLS, FIRM REGISTRATION #10067900
4047 STAHL ROAD, SUITE #3
SAN ANTONIO, TEXAS 78217
TEL (210) 599-4123
FAX (210) 599-4191

DRAWN BY: D.S.D. / J.R.C. / B.A.D
JOB NO: 170015-00
FIELD WORK COMP: 03-27-17

STATE OF TEXAS
REGISTERED
D. SCOTT DYE
5315
PROFESSIONAL LAND SURVEYOR

STATE OF TEXAS
COUNTY OF BEXAR

THE ABOVE SURVEY WAS PREPARED FROM AN ACTUAL SURVEY MADE ON THE GROUND UNDER MY SUPERVISION. MUNICIPAL RECORDS NOT RESEARCHED.

THIS 4TH DAY OF APRIL 2017, A.D.

D. SCOTT DYE R.P.L.S. NO. 5315

Z:\2017\170015-00 Hollow Hill 4334 (As-Built)\dwg\170015-00 Hollow Hill 4334 (As-Built).dwg

COPYRIGHT © 2017 DYE ENTERPRISES, ALL RIGHTS RESERVED.